


Unit # 115 septic Map

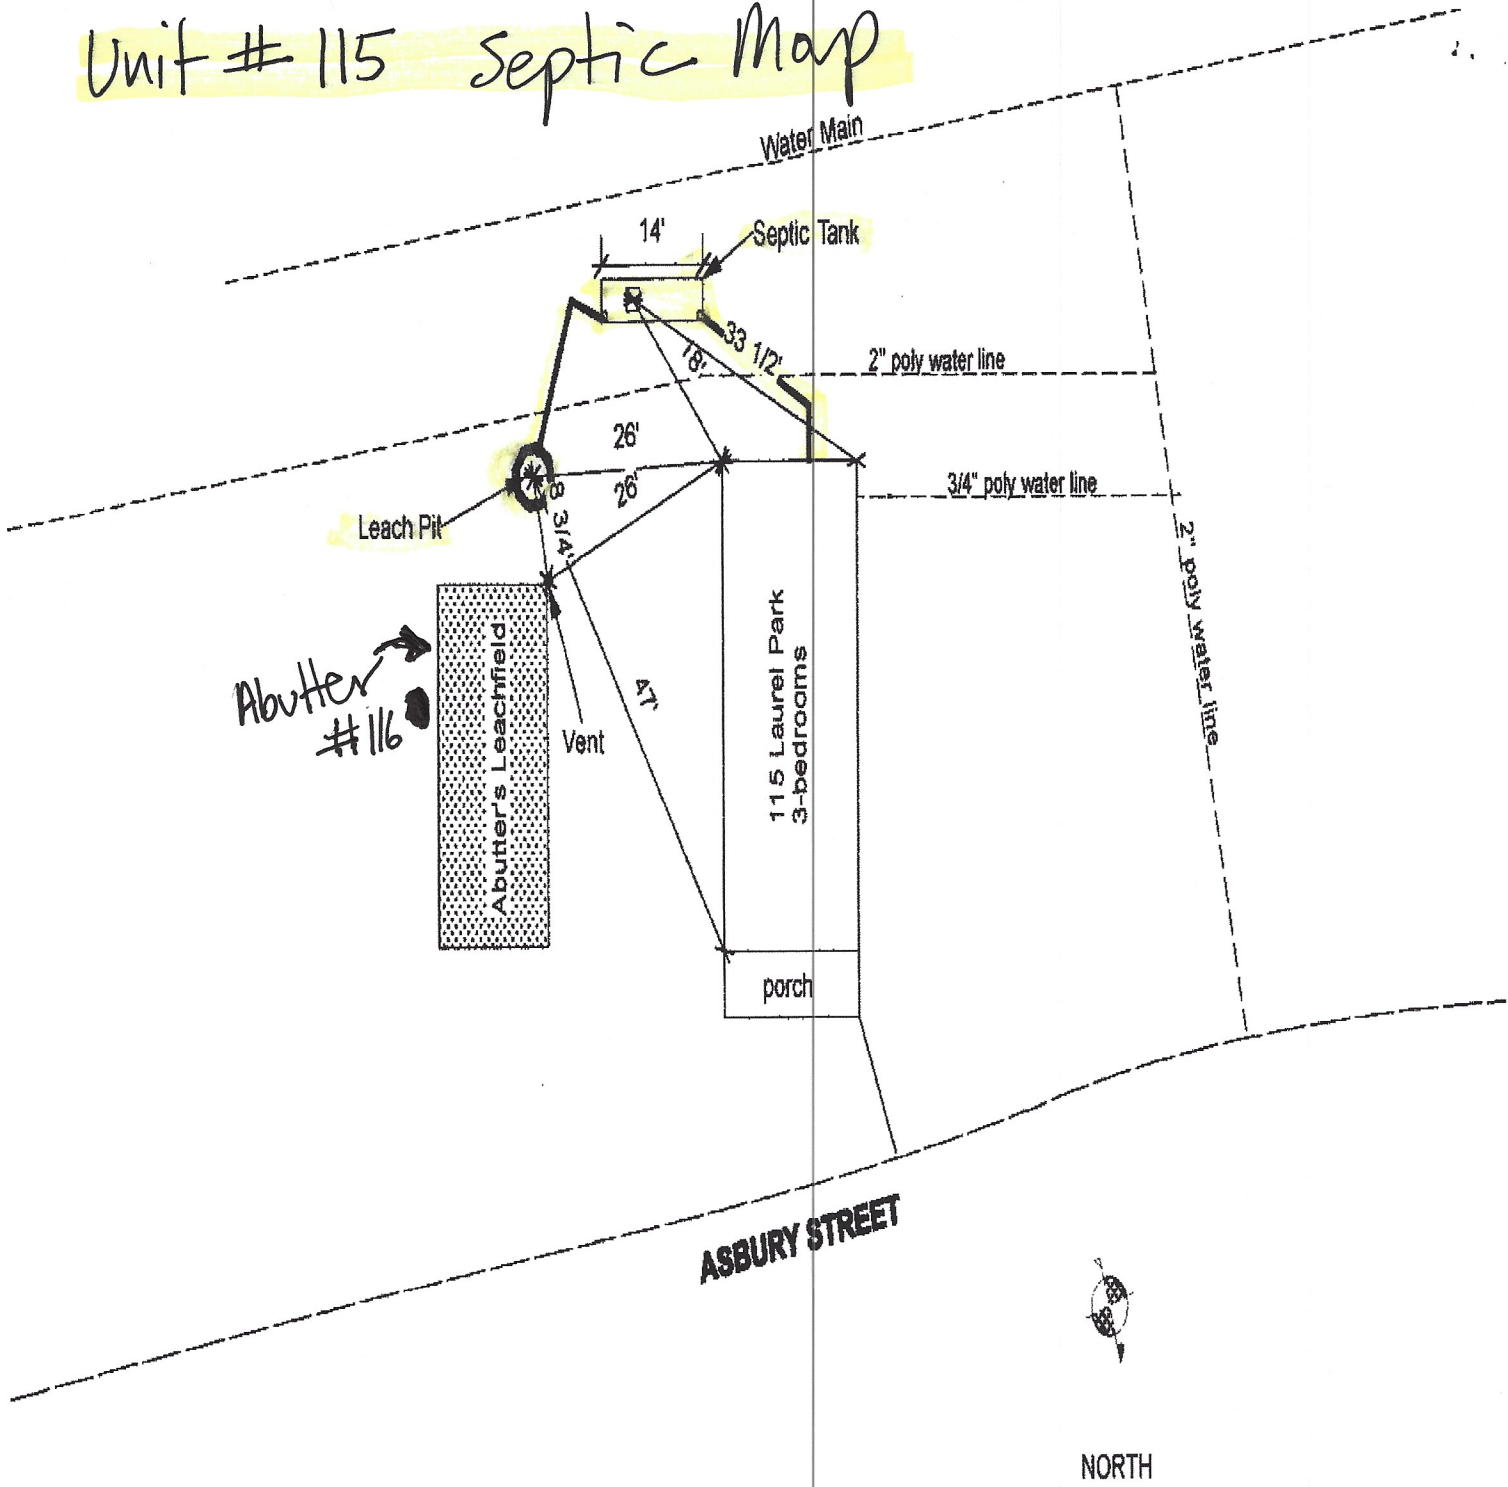

ASBURY STREET



NORTH

As-Built Drawing Existing Septic System	Date: 8/16/2015	Owner: John Cruz		HOMESTEAD INC. Thomas S. Leue R.S.
Scale: 1 : 20' Except as Noted	Revision Date:	115 Laurel Park Northampton, MA 01060		1664 Cape St. Williamsburg, MA 01096 [413] 628-4533