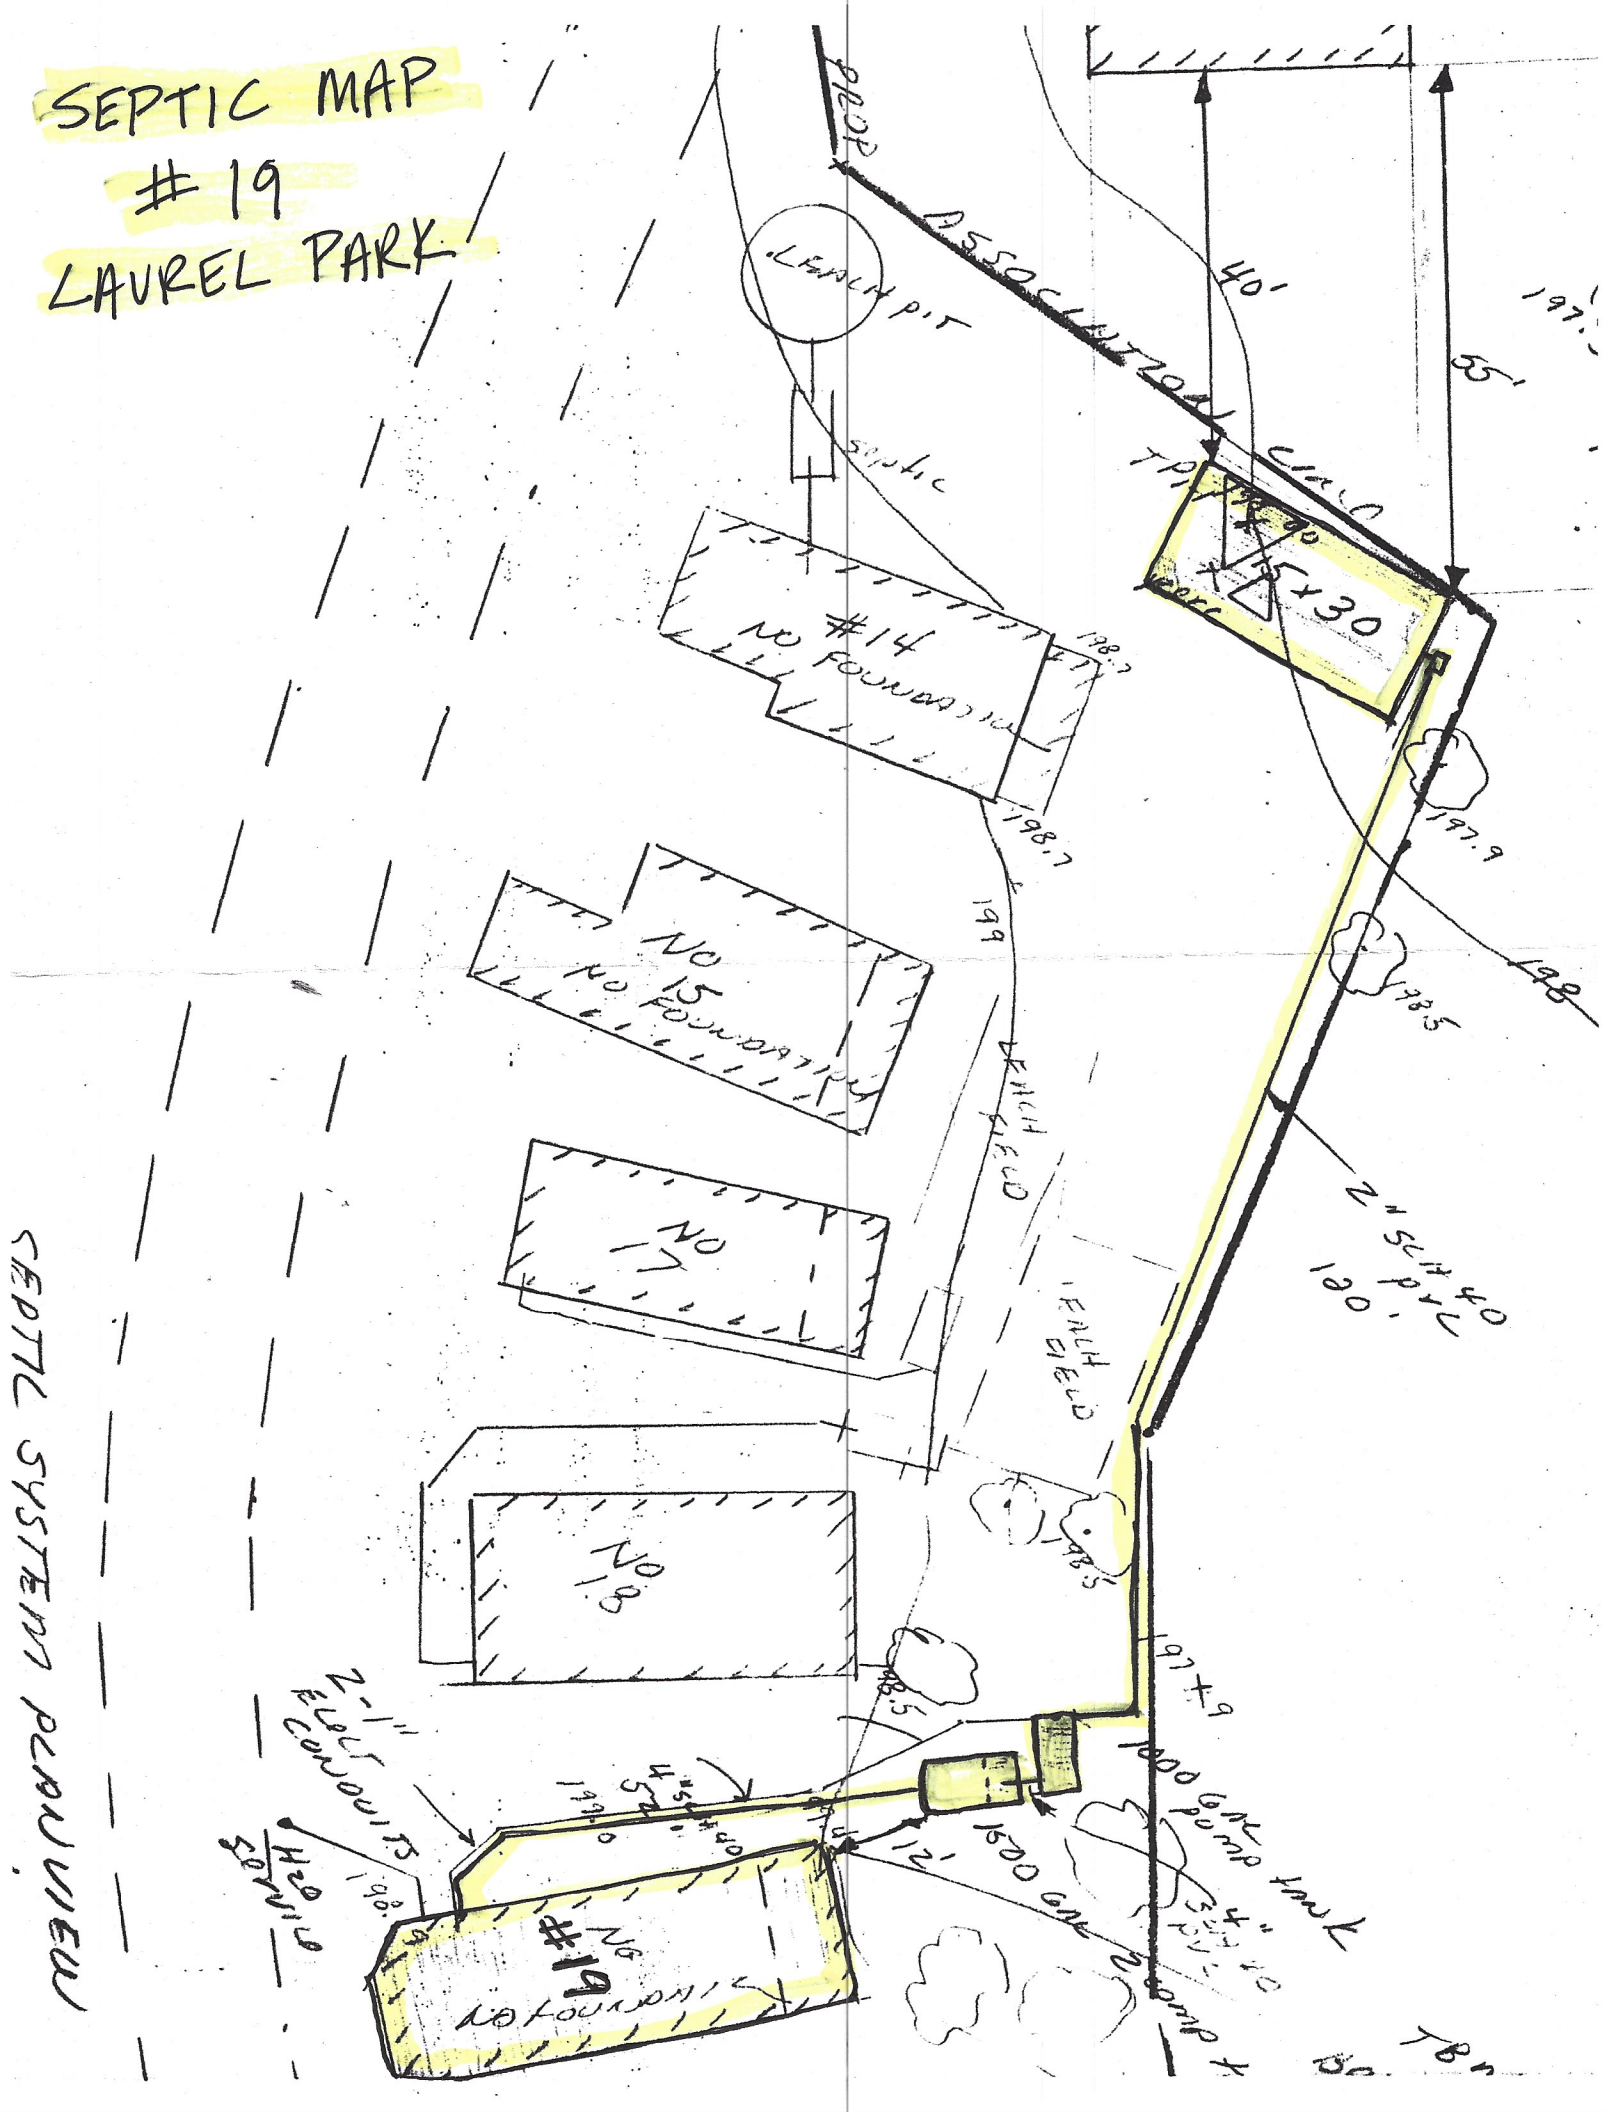
SEPTIC MAP
#19
LAUREL PARK
ASSOCIATION ROAD
LEACH PIT
SEPTIC
#14
NO FOUNDATION
NO 15
NO FOUNDATION
NO 17
LEACH FIELD
LEACH FIELD
2" SCH 40 PVC
120'
1500 GAL
4" SCH 40 PVC
#19
NO FOUNDATION
2-1" ELEC CONDUITS
4" SCH 40 PVC
H2O SERVICE
SEPTIC SYSTEM PLAN VIEW
40'
65'
+30
198.7
198.7
199
197.9
198
198.5
198.5
197+9
198.5
199+0
+40
12'