


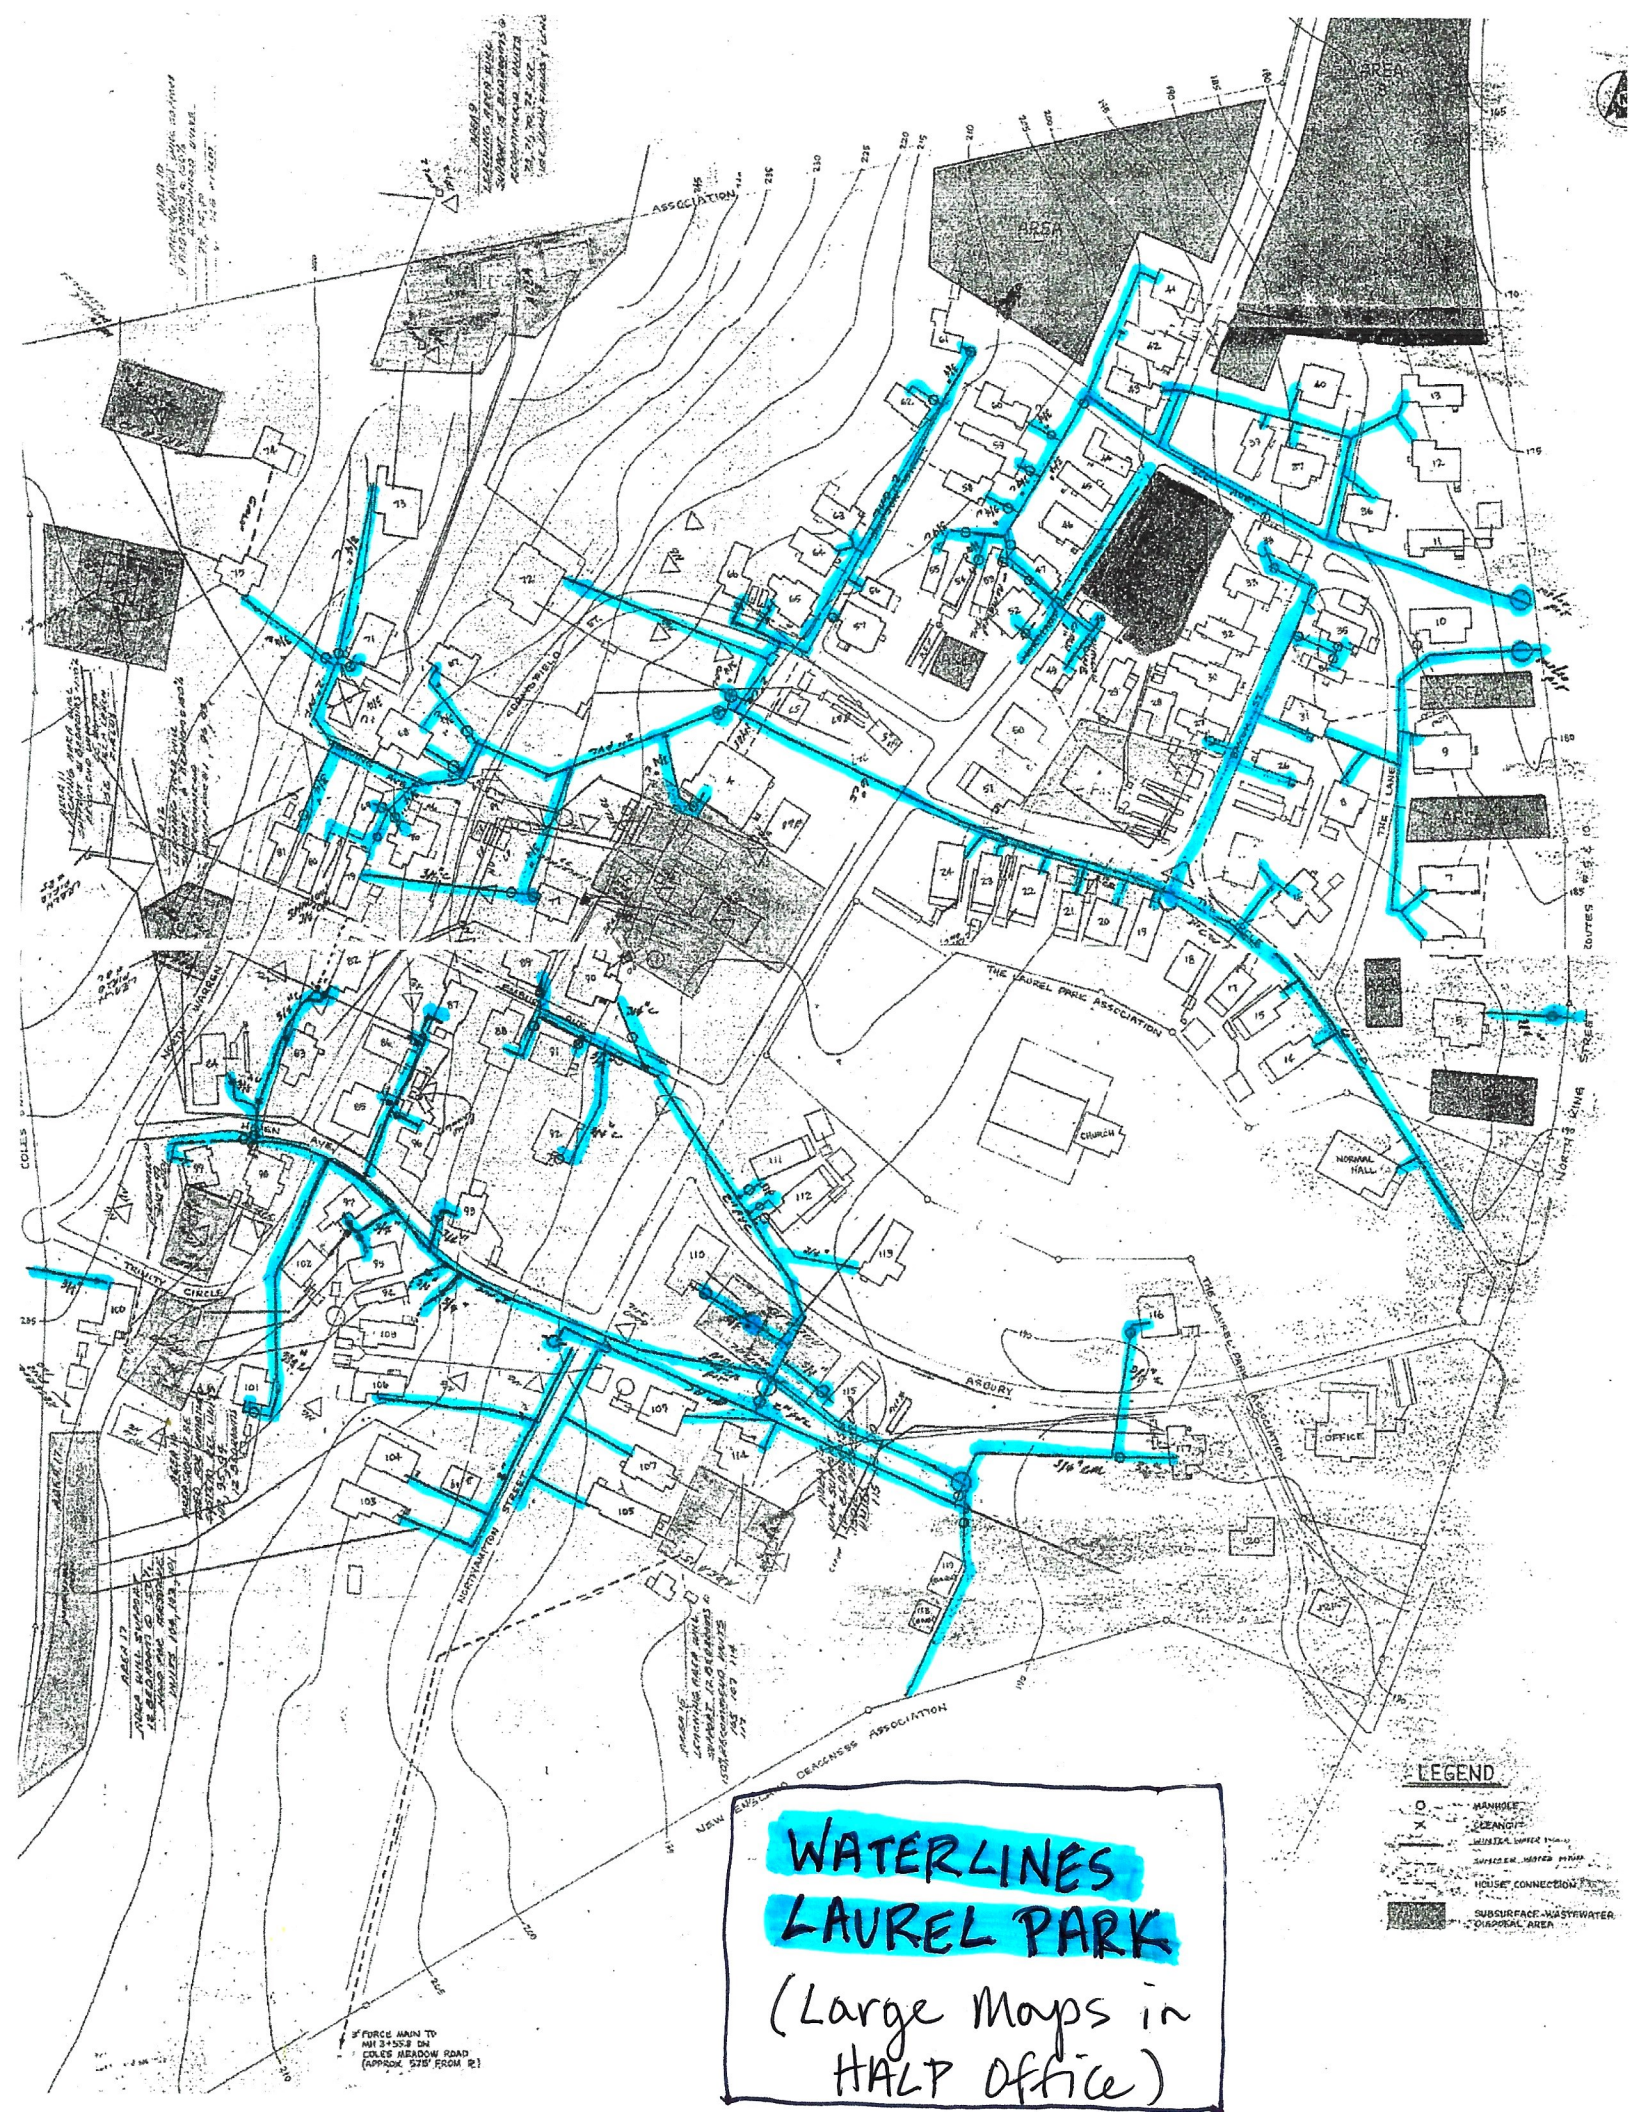

WATERLINES LAUREL PARK

(Large Maps in
HALP Office)

LEGEND

- MANHOLE
- ✕ CLEANOUT

FORCE MAIN TO
(APPROX 575' FROM #1)