


Laurel Park
2001 Building Directory
assembled by Dan Richardson, 109

Water Meter Locations
Large meters are shared, small are single units

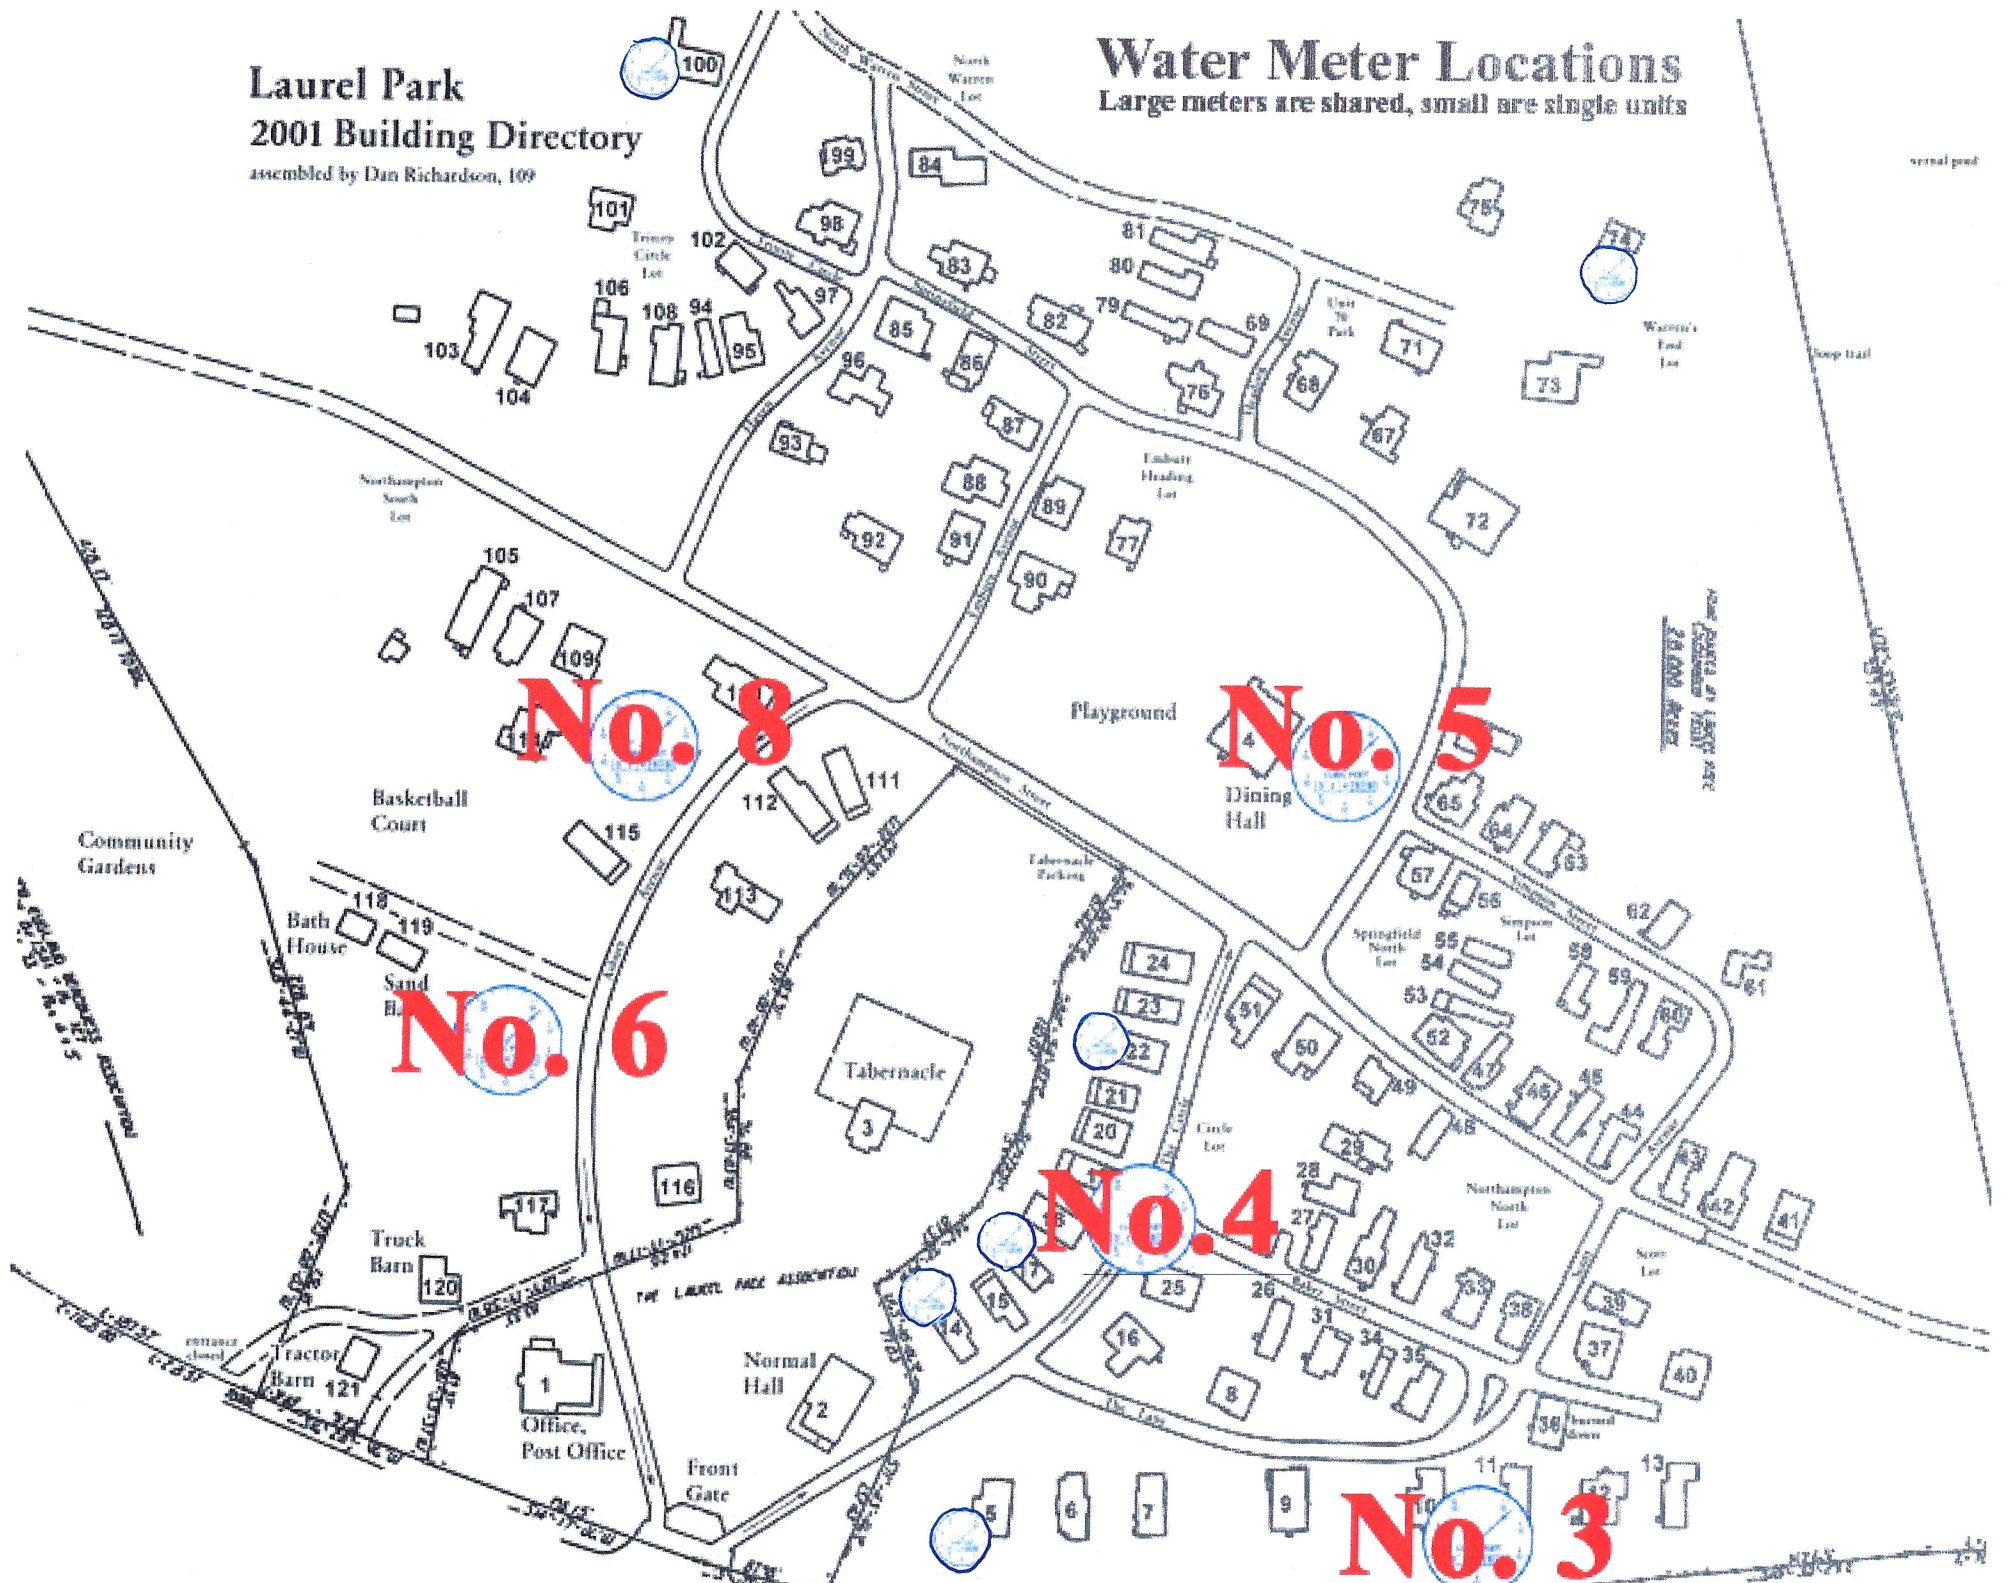

Coles Meadow

R.D.

METERS AT LAUREL PARK

Laurel Park
Northampton Mass

Max. Speed Limit

15 miles per hr

* Single House Meter

* 100

IN HOUSE

101

99

84

98

97

-1

-2

